


GENERAL ELECTRICAL NOTES

- ALL WORK SHALL CONFORM WITH ALL LOCAL, STATE, FEDERAL ORDINANCES, FLORIDA BUILDING CODE 2010 AND ADDENDUMS, NEC 2008, COVERING THE INSTALLATION OF THE ELECTRICAL SYSTEM. IF WORK AS LAID OUT, INDICATED OR SPECIFIED IS CONTRARY TO OR CONFLICTS WITH LOCAL ORDINANCES, BUILDING CODES AND REGULATIONS, THE CONTRACTOR SHALL REPORT IN WRITING TO THE ARCHITECT/ENGINEER BEFORE SUBMITTING A BID. THE ARCHITECT/ENGINEER WILL THEN ISSUE INSTRUCTIONS AS HOW TO PROCEED.
- THE DRAWING ARE TO BE CONSIDERED DIAGRAMMATIC, NOT NECESSARILY SHOWING IN DETAIL OR TO SCALE ALL OF THE MINOR ITEMS, UNLESS SHOWING IN DETAIL OR TO SCALE ALL OF THE MINOR ITEMS, UNLESS SPECIFIC DIMENSIONS ARE SHOWN. THE STRUCTURAL, ARCHITECTURAL, AND SITE CONDITIONS SHALL GOVERN THE EXACT LOCATIONS. CONTRACTOR SHALL FOLLOW DRAWINGS IN LAYING OUT WORK, CHECK DRAWINGS OF ALL TRADES TO VERIFY SPACES IN WHICH WORK WILL BE INSTALLED AND MAINTAIN MAXIMUM HEAD ROOM, OR SPACE CONDITIONS AT ALL POINTS. WHERE HEADROOM, OR SPACE CONDITIONS APPEAR INADEQUATE, ARCHITECT/ENGINEER SHALL BE NOTIFIED BEFORE PROCEEDING WITH INSTALLATION. THIS CONTRACTOR SHALL, WITHOUT EXTRA CHARGE, MAKE FIELD MODIFICATION IN LAYOUT AS NEEDED TO PREVENT CONFLICT WITH WORK OF VARIOUS TRADES OR FOR PROPER EXECUTION OF THE WORK.
- INSTALL MATERIALS AND EQUIPMENT IN A NEAT AND FIRST CLASS WORKMANLIKE MANNER. THE OWNER RESERVES THE RIGHT TO DIRECT REMOVAL AND REPLACEMENT OF ITEMS WHICH, IN HIS OPINION, DO NOT PRESENT A NEAT AND WORKMANLIKE APPEARANCE. REMOVAL AND REPLACEMENT IS TO BE DONE IMMEDIATELY WHEN DIRECTED BY THE OWNER IN WRITING, AT THE SOLE EXPENSE OF CONTRACTOR.
- START OF WORK BY CONTRACTOR SHALL BE CONSIDERED AS ACCEPTANCE BY HIM OF ALL CLAIMS OR QUESTIONS AS TO SUITABILITY OF THE WORK OF OTHER TRADES OR OTHER CONTRACTORS TO RECEIVE HIS WORK. THIS CONTRACTOR SHALL REMOVE AND REPLACE, AT HIS EXPENSE, ALL ELECTRICAL WORK WHICH MAY HAVE TO BE REMOVED BECAUSE OF INTERFERENCE WITH OTHER TRADES.
- THIS CONTRACTOR SHALL OBTAIN AND PAY ALL INSURANCE, FEES, PERMITS ASSOCIATION DUES, ROYALTIES, AND TAXES OF WHATEVER NATURE SHALL APPLY TO THIS WORK. HE SHALL ALSO PAY ALL INSPECTION FEES AS MAY BE REQUIRED BY LAW OR ORDINANCE AND SHALL KEEP THE OWNER HARMLESS FROM ANY DAMAGE AND EXPENSE ARISING FROM ANY VIOLATION OF THE LAWS, RULES OR ORDINANCES.
- ALL WIRE COPPER, IN RACEWAY, OR NON METALLIC TUBING (NMT) AND NM (ROMEX) CABLE AS PERMITTED BY NEC 334.
- PROVIDE MEANS "FURNISH AND INSTALL".
- COORDINATE WORK WITH WORK OF OTHER TRADES TO AVOID ALL CONFLICTS.
- PROVIDE A COMPLETE OPERATIONAL SYSTEM, EVERYTHING CONNECTED, READY FOR USE.
- PROVIDE ALL WIRING DEVICES. AVOID 1/2 SIZE BREAKERS UNLESS APPROVED BY ENGINEER.
- PRIOR TO CIRCUITING HOMERUNS, CONTRACTOR SHALL FIELD VERIFY EXISTING LOADS, SPARES, SPACES, AVAILABILITY, AND WIRE ACCORDINGLY. IDENTIFY CLEARLY ON A TYPE WRITTEN PANEL SCHEDULE ALL CIRCUITS TO CORRESPOND WITH EXISTING, AND NEW CONDITIONS. ATTACH INSIDE THE PERTAINING PANEL DOOR.
- RACEWAYS: ALL UNDERGROUND RACEWAYS TO BE PVC. INSIDE CONCRETE SLAB EMT WITH APPROVED SET SCREW FITTING, INSIDE PARTITION EMT, AND, ENT WHERE ALLOWED. FOR FLOOR PENETRATION USE ONLY EMT.
- SHOP DRAWINGS: THIS CONTRACTOR SHALL FURNISH THE ENGINEER WITH SHOP DRAWINGS OF EQUIPMENT PRIOR TO PURCHASE FOR APPROVAL.
- TESTING: THE CONTRACTOR SHALL TEST ALL WORK AND EQUIPMENT AS DIRECTED BY THE ARCHITECT AND BY AUTHORITIES HAVING JURISDICTION, FURNISHING ALL EQUIPMENT AND NECESSARY PERSONNEL AND ELECTRIC POWER. THE ENTIRE INSTALLATION SHALL BE TESTED FOR SHORTS, GROUNDS AND OPEN CIRCUITS AND ALL DEFECTS SHALL BE DEMONSTRATED TO BE IN PROPER WORKING AND OPERATING CONDITION TO THE COMPLETE SATISFACTION OF THE ENGINEER.
- GUARANTEES: ONE YEAR AFTER THE DATE OF ACCEPTANCE BY OWNER.
- AT COMPLETION OF PROJECT THE ELECTRICAL CONTRACTOR SHALL GIVE THE OWNER AN AS-BUILT SET OF DRAWINGS SHOWING THE EXACT ELECTRICAL INSTALLATION. ALL EQUIPMENT AND MATERIALS SHALL BE GUARANTEED FOR.
- BEFORE BIDDING THE JOB THE ELECTRICAL CONTRACTOR SHALL VISIT THE SITE AND BECOME FAMILIAR WITH ALL EXISTING CONDITIONS.
- ALL EXISTING ELECTRICAL DEVICES AND EQUIPMENT AND THEIR ASSOCIATED WIRING INSIDE THE REMOVED WALLS SHALL BE DISCONNECTED AND REMOVED.
- CONTRACTOR SHALL COLOR CODE THE FEEDER, AND BRANCH WIRING AS FOLLOWS: 120/240V: BLACK, RED, BLUE, AND WHITE.
- CONTRACTOR SHALL FIRE-STOP AND SEAL ALL PATHWAYS THROUGH FLOORS, WALLS, AND OTHER RELATED PENETRATIONS IN ACCORDANCE WITH FBC.

ELECTRICAL LEGEND

SYMBOL	DESCRIPTION
	DUPLEX RECEPTACLE GROUNDING TYPE, 20A, MH=18" AFF
	DUPLEX RECEPTACLE, SAME AS ABOVE, MH=48" AFF
	SPECIAL PURPOSE RECEPTACLE, RATING TO MATCH CB AS NOTED, MINIMUM 20A 240V IP UON
	JUNCTION BOX FLUSH MOUNTED
	TELEPHONE/DATA JACK OUTLETS, TYPE AS SELECTED BY OWNER, 3/4" EC WITH PULL STRING TO TELEPHONE/DATA BOARD IN ELECTRICAL ROOM. MH=15" AFF OR AS DIRECTED BY OWNER. PROVIDE PLENUM RATED CABLE IN PLENUM SPACES IF NO EC USED.
	CABLE/TV JACK OUTLET, TYPE AS SELECTED BY OWNER, 3/4" EC WITH PULL STRING TO TELEPHONE BOARD UON. MH=18" AFF
	120V EXHAUST FAN TIED TO BATHROOM CIRCUIT
	FUSED DISCONNECT SWITCH RATED 250V, INDICATING 2 POLES, 40A SWITCH, 40 AMP FUSES, NEMA-1, "3R" INDICATES NEMA-3R POLES, SWITCH SIZE AND FUSES SIZED AS NOTE ON PLANS
	PANELBOARD, DESCRIPTION PER PANEL SCHEDULE
	HOMERUN TO PANEL, TICKS INDICATE PHASE AND NEUTRAL NO TICKS INDICATE PHASE AND NEUTRAL CIRCUIT
	STARTER/DISCONNECT
	CONDUIT RUN UNDERGROUND
	CONDUIT RUN CONCEALED IN CEILINGS, WALL OR SLAB
	FLEXIBLE CONDUIT
	IONIZATION SMOKE DETECTOR/CARBON MONOXIDE DETECTOR COMBO, 120V, WITH BATTERY BACK UP INTERCONNECTED, 36" MINIMUM FROM AC SUPPLY/RETURN GRILLS.
	TOGGLE SWITCH, QUIET TYPE, 20A, 15/277. MH=48" AFF
	TOGGLE DIMMER SWITCH, QUIET TYPE, 20A, 125/277. MH=48" AFF
	3-WAY DIMMER SWITCH, SAME AS ABOVE
	GROUND FAULT INTERRUPTOR
	WEATHER PROOF, NEMA 3R FOR ALL EXTERIOR LOCATION DEVICES
	VAPOR PROOF
	RELOCATED
	REPLACED
	EXISTING

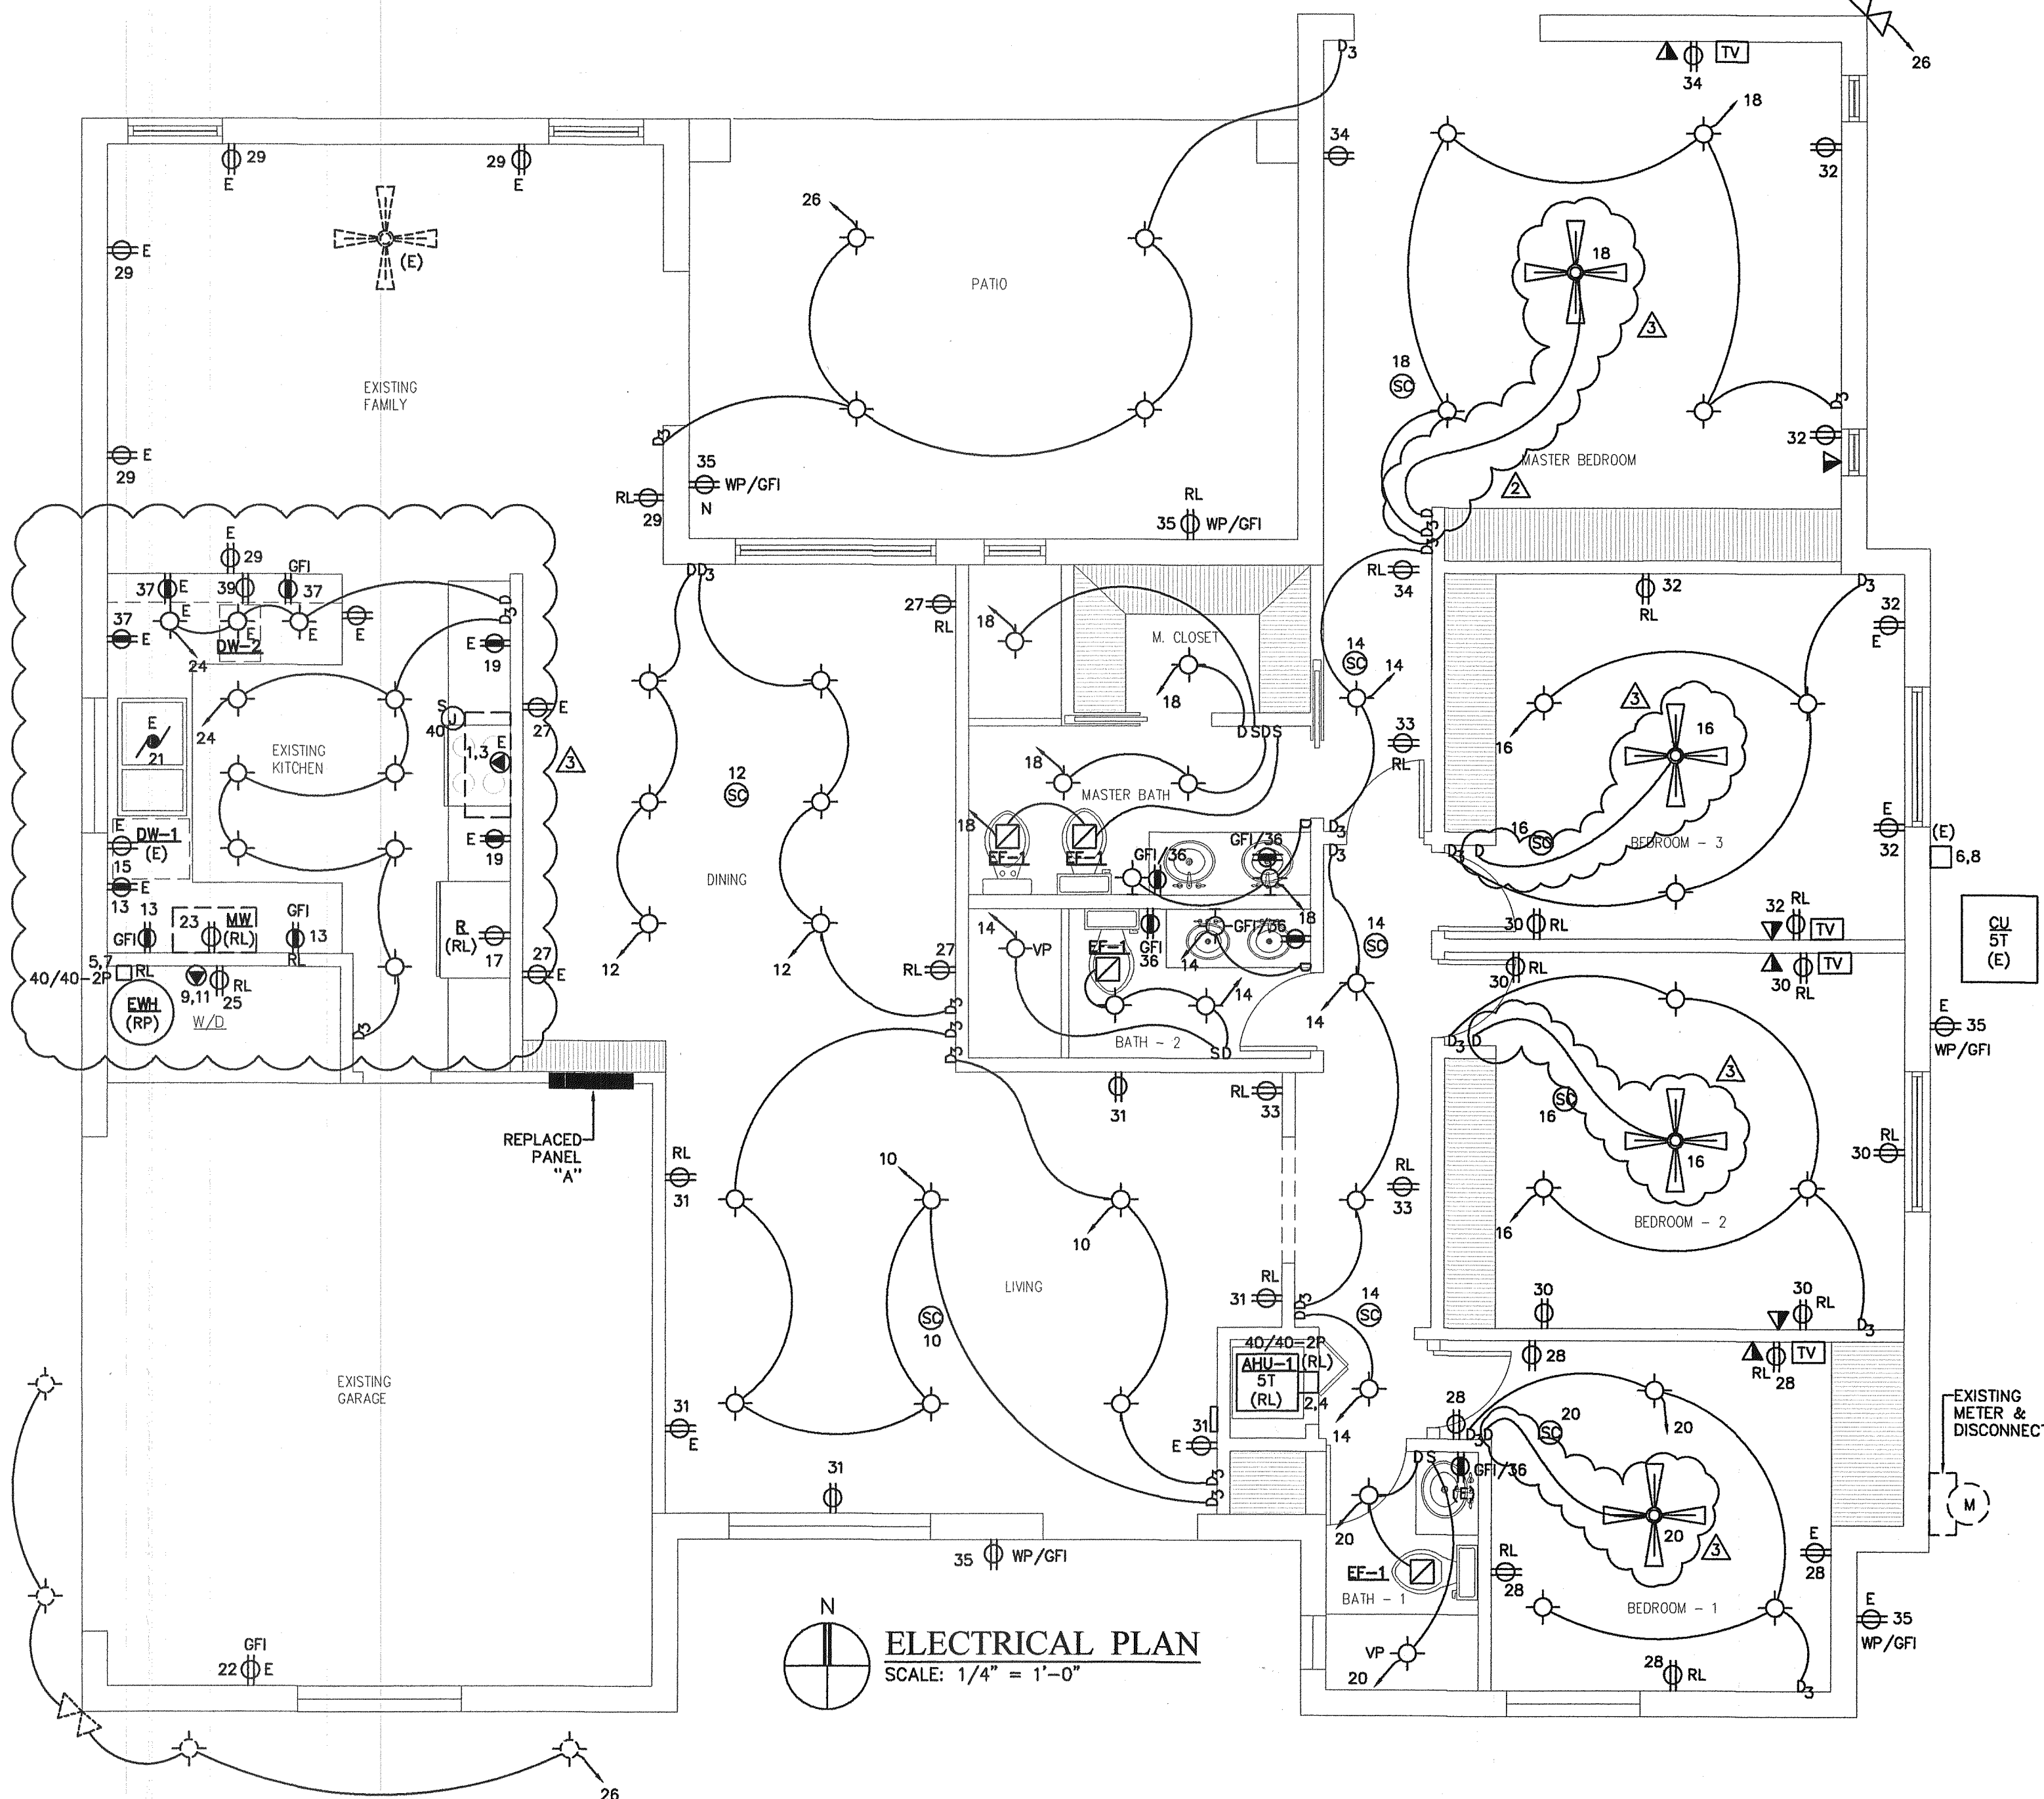


ELECTRICAL PLAN
SCALE: 1/4" = 1'-0"

TYPE:	LOAD CENTER	REPLACED	MAIN BUS:
SERVICE	1P-3W	PANEL "A"	150A
VOLTS:	120/240	MIN 22K AIC	NEUTRAL: 150A
MOUNT:	FLUSH		MAINS: 150MGB
CKT No	REMARKS	POL ES	TRIP
1	RANGE	2	50
3			
5	WATER HEATER	2	30
7			
9	DRYER	2	30
11			
13	SMALL APPLIANCES	1	20
15	DW-1		
17	REFRIGERATOR		
19	SMALL APPLIANCES		
21	GARBAGE DISPOSAL		
23	MICROWAVE		
25	WASHING MACHINE		
27	RECEPTACLES		
29			
31			
33			
35	MAINT. RECEPT		
37	SMALL APPLIANCES		
39	DW-2		
41	SPACE		
TOTAL	30.0		
TOTAL CONNECTED LOAD	47.6	198AMPS	
TOTAL DEMAND LOAD	8.1	10	

- EXISTING NON-COINCIDENTAL AC LOAD (COOLING LARGEST).
- UNLESS OTHERWISE NOTED ALL CB'S ARE EXISTING TO REMAIN AND TO BE RECONNECTED TO REPLACED PANEL.
- PROVIDE NEW CKT AS SHOWN.
- 2500SF * 3VA/SF = 7.5KVA
- EXISTING 150A-240V SERVICE IS ADEQUATE TO HANDLE THIS REMODELING.

EXISTING RISER SHOWN FOR REFERENCE ONLY.

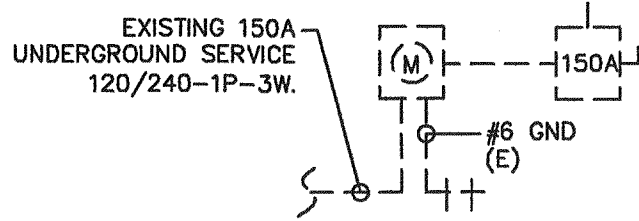

EXISTING POWER RISER NTS

RISER LEGEND

	EXISTING
	REPLACED

LIGHTING FIXTURE SCHEDULE

SYMBOL	TYPE	DESCRIPTION AND MANUFACTURER INFORMATION	LOCATION
	A	120V LIGHTING FIXTURE SURFACE MOUNTED, 100W MAX	GENERAL AREAS
	B	FLOOD LTG	EXTERIOR
	C	FLUORESCENT WALL SCONCE LIGHT FIXTURE, 26W MAX	MASTER BATH
	D	FAN/LIGHT, PENDANT, 200W MAX.	BEDROOMS

NOTES:

- MANUFACTURER'S AND MODEL NUMBERS ARE SHOWN FOR GENERAL REFERENCE ONLY. BEFORE COMMENCING WORK CONTRACTOR SHALL VERIFY WITH OWNER FOR EXACT FIXTURE MODELS AND TYPES.
- UNLESS OTHERWISE NOTED ALL FIXTURES SHALL BE 120V, INDIVIDUALLY FUSED.
- FLUORESCENT FIXTURES SHALL BE ENERGY EFFICIENT ELECTRONIC BALLASTS AND T8 LAMPS.

ELECTRICAL SCOPE OF WORK AND NOTES:

- SCOPE OF WORK CONSISTS OF INTERIOR REMODELING AND ADDITION OF THIS EXISTING RESIDENCE AS SHOWN ON PLANS. COMPLY WITH NEC 2008 AND FBC 2010 ADDENDUMS.
- EXISTING 150A-2P-240V ELECTRICAL SERVICE TO REMAIN, REPLACE EXISTING PANEL.
- BEFORE COMMENCING WORK CONTRACTOR SHALL VERIFY EXISTING CONDITIONS, AND COORDINATE WITH ARCH/PLUMBING, MECHANICAL PLANS FOR DUCTWORK LOCATIONS AND CEILING SPACES.
- ROOM RECEPTACLES, LIGHTING SHALL BE FED THROUGH ARC-FAULT CIRCUIT BREAKERS IN ACCORDANCE WITH NEC 210-12.
- BEFORE COMMENCING WORK CONTRACTOR SHALL COORDINATE WITH ARCH/OWNER AND SELECTED MANUFACTURER FAN/LTG VENDOR FOR CLG. J-BOX AND PENDANT FIXTURE SUPPORTS AS PER NEC 314.23, 410.16, FAN W/LIGHT 200W MAX.
- PROVIDE ACCESS FOR ALL ELECTRICAL PANELS AS PER NEC.
- CONTRACTOR TO COORDINATE AND VERIFY LIGHTING TYPE AND MODELS, AND CEILING TYPES WITH ARCH/OWNER.
- UNLESS OTHERWISE NOTED CONTRACTOR SHALL PROVIDE FOR A COMPLETE ELECTRICAL OPERATIONAL SYSTEM FOR THIS HOTEL REMODELING AS PER NEC.
- BATHROOM RECEPTACLE IN LAVATORY SHALL BE GFI.
- IONIZATION TYPE SMOKE DETECTOR WITH BATTERY BACK-UP WIRING TO UNSWITCHED ARC-FAULT 120V CIRCUIT, INTERLOCKED TO ACTIVATE IN ALARM ANNUNCIATION.
- SURFACE MTD. CLOTH CLOSET FLUORESCENT FIXTURE SHALL BE INSTALLED 6" MINIMUM CLEARANCE TO STORAGE SPACE AS PER NEC 410-8.
- ALL NEW RECEPTACLES SHALL COMPLY WITH NEC 2008 ART 406.11 TAMPER RESISTANT AS SPECIFIED IN ART 210.52
- ALL LUMINAIRES SHALL HAVE A LISTING WITH A NATIONAL RECOGNIZED TESTING LABORATORY (NRTL) SUCH AS UL.
- REMOVE ALL WIRING, CONDUIT, SWITCHES NOT BEING RE-USED.
- A MINIMUM OF 50% OF THE LAMPS IN PERMANENTLY INSTALLED LIGHTING FIXTURES SHALL BE HIGH EFFICIENCY LAMPS, AS PER E404.



certified GENERAL CONTRACTOR
9450 NW 53rd St. #104 Doral, FL 33166
305.994.8842 - 1st/2nd/3rd/4th/5th/6th/7th/8th/9th/10th/11th/12th/13th/14th/15th/16th/17th/18th/19th/20th/21st/22nd/23rd/24th/25th/26th/27th/28th/29th/30th/31st/32nd/33rd/34th/35th/36th/37th/38th/39th/40th/41st/42nd/43rd/44th/45th/46th/47th/48th/49th/50th/51st/52nd/53rd/54th/55th/56th/57th/58th/59th/60th/61st/62nd/63rd/64th/65th/66th/67th/68th/69th/70th/71st/72nd/73rd/74th/75th/76th/77th/78th/79th/80th/81st/82nd/83rd/84th/85th/86th/87th/88th/89th/90th/91st/92nd/93rd/94th/95th/96th/97th/98th/99th/100th/101st/102nd/103rd/104th/105th/106th/107th/108th/109th/110th/111th/112th/113th/114th/115th/116th/117th/118th/119th/120th/121st/122nd/123rd/124th/125th/126th/127th/128th/129th/130th/131st/132nd/133rd/134th/135th/136th/137th/138th/139th/140th/141st/142nd/143rd/144th/145th/146th/147th/148th/149th/150th/151st/152nd/153rd/154th/155th/156th/157th/158th/159th/160th/161st/162nd/163rd/164th/165th/166th/167th/168th/169th/170th/171st/172nd/173rd/174th/175th/176th/177th/178th/179th/180th/181st/182nd/183rd/184th/185th/186th/187th/188th/189th/190th/191st/192nd/193rd/194th/195th/196th/197th/198th/199th/200th/201st/202nd/203rd/204th/205th/206th/207th/208th/209th/210th/211st/212nd/213th/214th/215th/216th/217th/218th/219th/220th/221st/222nd/223rd/224th/225th/226th/227th/228th/229th/230th/231st/232nd/233rd/234th/235th/236th/237th/238th/239th/240th/241st/242nd/243rd/244th/245th/246th/247th/248th/249th/250th/251st/252nd/253rd/254th/255th/256th/257th/258th/259th/260th/261st/262nd/263rd/264th/265th/266th/267th/268th/269th/270th/271st/272nd/273rd/274th/275th/276th/277th/278th/279th/280th/281st/282nd/283rd/284th/285th/286th/287th/288th/289th/290th/291st/292nd/293rd/294th/295th/296th/297th/298th/299th/300th/301st/302nd/303rd/304th/305th/306th/307th/308th/309th/310th/311st/312nd/313th/314th/315th/316th/317th/318th/319th/320th/321st/322nd/323rd/324th/325th/326th/327th/328th/329th/330th/331st/332nd/333rd/334th/335th/336th/337th/338th/339th/340th/341st/342nd/343rd/344th/345th/346th/347th/348th/349th/350th/351st/352nd/353rd/354th/355th/356th/357th/358th/359th/360th/361st/362nd/363rd/364th/365th/366th/367th/368th/369th/370th/371st/372nd/373rd/374th/375th/376th/377th/378th/379th/380th/381st/382nd/383rd/384th/385th/386th/387th/388th/389th/390th/391st/392nd/393rd/394th/395th/396th/397th/398th/399th/400th/401st/402nd/403rd/404th/405th/406th/407th/408th/409th/410th/411st/412nd/413th/414th/415th/416th/417th/418th/419th/420th/421st/422nd/423rd/424th/425th/426th/427th/428th/429th/430th/431st/432nd/433rd/434th/435th/436th/437th/438th/439th/440th/441st/442nd/443rd/444th/445th/446th/447th/448th/449th/450th/451st/452nd/453rd/454th/455th/456th/457th/458th/459th/460th/461st/462nd/463rd/464th/465th/466th/467th/468th/469th/470th/471st/472nd/473rd/474th/475th/476th/477th/478th/479th/480th/481st/482nd/483rd/484th/485th/486th/487th/488th/489th/490th/491st/492nd/493rd/494th/495th/496th/497th/498th/499th/500th/501st/502nd/503rd/504th/505th/506th/507th/508th/509th/510th/511st/512nd/513th/514th/515th/516th/517th/518th/519th/520th/521st/522nd/523rd/524th/525th/526th/527th/528th/529th/530th/531st/532nd/533rd/534th/535th/536th/537th/538th/539th/540th/541st/542nd/543rd/544th/545th/546th/547th/548th/549th/550th/551st/552nd/553rd/554th/555th/556th/557th/558th/559th/560th/561st/562nd/563rd/564th/565th/566th/567th/568th/569th/570th/571st/572nd/573rd/574th/575th/576th/577th/578th/579th/580th/581st/582nd/583rd/584th/585th/586th/587th/588th/589th/590th/591st/592nd/593rd/594th/595th/596th/597th/598th/599th/600th/601st/602nd/603rd/604th/605th/606th/607th/608th/609th/610th/611st/612nd/613th/614th/615th/616th/617th/618th/619th/620th/621st/622nd/623rd/624th/625th/626th/627th/628th/629th/630th/631st/632nd/633rd/634th/635th/636th/637th/638th/639th/640th/641st/642nd/643rd/644th/645th/646th/647th/648th/649th/650th/651st/652nd/653rd/654th/655th/656th/657th/658th/659th/660th/661st/662nd/663rd/664th/665th/666th/667th/668th/669th/670th/671st/672nd/673rd/674th/675th/676th/677th/678th/679th/680th/681st/682nd/683rd/684th/685th/686th/687th/688th/689th/690th/691st/692nd/693rd/694th/695th/696th/697th/698th/699th/700th/701st/702nd/703rd/704th/705th/706th/707th/708th/709th/710th/711st/712nd/713th/714th/715th/716th/717th/718th/719th/720th/721st/722nd/723rd/724th/725th/726th/727th/728th/729th/730th/731st/732nd/733rd/734th/735th/736th/737th/738th/739th/740th/741st/742nd/743rd/744th/745th/746th/747th/748th/749th/750th/751st/752nd/753rd/754th/755th/756th/757th/758th/759th/760th/761st/762nd/763rd/764th/765th/766th/767th/768th/769th/770th/771st/772nd/773rd/774th/775th/776th/777th/778th/779th/780th/781st/782nd/783rd/784th/785th/786th/787th/788th/789th/790th/791st/792nd/793rd/794th/795th/796th/797th/798th/799th/800th/801st/802nd/803rd/804th/805th/806th/807th/808th/809th/810th/811st/812nd/813th/814th/815th/816th/817th/818th/819th/820th/821st/822nd/823rd/824th/825th/826th/827th/828th/829th/830th/831st/832nd/833rd/834th/835th/836th/837th/838th/839th/840th/841st/842nd/843rd/844th/845th/846th/847th/848th/849th/850th/851st/852nd/853rd/854th/855th/856th/857th/858th/859th/860th/861st/862nd/863rd/864th/865th/866th/867th/868th/869th/870th/871st/872nd/873rd/874th/875th/876th/877th/878th/879th/880th/881st/882nd/883rd/884th/885th/886th/887th/888th/889th/890th/891st/892nd/893rd/894th/895th/896th/897th/898th/899th/900th/901st/902nd/903rd/904th/905th/906th/907th/908th/909th/910th/911st/912nd/913th/914th/915th/916th/917th/918th/919th/920th/921st/922nd/923rd/924th/925th/926th/927th/928th/929th/930th/931st/932nd/933rd/934th/935th/936th/937th/938th/939th/940th/941st/942nd/943rd/944th/945th/946th/947th/948th/949th/950th/951st/952nd/953rd/954th/955th/956th/957th/958th/959th/960th/961st/962nd/963rd/964th/965th/966th/967th/968th/969th/970th/971st/972nd/973rd/974th/975th/976th/977th/978th/979th/980th/981st/982nd/983rd/984th/985th/986th/987th/988th/989th/990th/991st/992nd/993rd/994th/995th/996th/997th/998th/999th/1000th/1001st/1002nd/1003rd/1004th/1005th/1006th/1007th/1008th/1009th/1010th/1011st/1012nd/1013th/1014th/1015th/1016th/1017th/1018th/1019th/1020th/1021st/1022nd/1023rd/1024th/1025th/1026th/1027th/1028th/1029th/1030th/1031st/1032nd/1033rd/1034th/1035th/1036th/1037th/1038th/1039th/1040th/1041st/1042nd/1043rd/1044th/1045th/1046th/1047th/1048th/1049th/1050th/1051st/1052nd/1053rd/1054th/1055th/1056th/1057th/1058th/1059th/1060th/1061st/1062nd/1063rd/1064th/1065th/1066th/1067th/1068th/1069th/1070th/1071st/1072nd/1073rd/1074th/1075th/1076th/1077th/1078th/1079th/1080th/1081st/1082nd/1083rd/1084th/1085th/1086th/1087th/1088th/1089th/1090th/1091st/1092nd/1093rd/1094th/1095th/1096th/1097th/1098th/1099th/1100th/1101st/1102nd/1103rd/1104th/1105th/1106th/1107th/1108th/1109th/1110th/1111st/1112nd/1113th/1114th/1115th/1116th/1117th/1118th/1119th/1120th/1121st/1122nd/1123rd/1124th/1125th/1126th/1127th/1128th/1129th/1130th/1131st/1132nd/1133rd/1134th/1135th/1136th/1137th/1138th/1139th/1140th/1141st/1142nd/1143rd/1144th/1145th/1146th/1147th/1148th/1149th/1150th/1151st/1152nd/1153rd/1154th/1155th/1156th/1157th/1158th/1159th/1160th/1161st/1162nd/1163rd/1164th/1165th/1166th/1167th/1168th/1169th/1170th/1171st/1172nd/1173rd/1174th/1175th/1176th/1177th/1178th/1179th/1180th/1181st/1182nd/1183rd/1184th/1185th/1186th/1187th/1188th/1189th/1190th/1191st/1192nd/1193rd/1194th/1195th/1196th/1197th/1198th/1199th/1200th/1201st/1202nd/1203rd/1204th/1205th/1206th/1207th/1208th/1209th/1210th/1211st/1212nd/1213th/1214th/1215th/1216th/1217th/1218th/1219th/1220th/1221st/1222nd/1223rd/1224th/1225th/1226th/1227th/1228th/1229th/1230th/1231st/1232nd/1233rd/1234th/1235th/1236th/1237th/1238th/1239th/1240th/1241st/1242nd/1243rd/1244th/1245th/1246th/1247th/1248th/1249th/1250th/1251st/1252nd/1253rd/1254th/1255th/1256th/1257th/1258th/1259th/1260th/1261st/1262nd/1263rd/1264th/1265th/1266th/1267th/1268th/1269th/1270th/1271st/1272nd/1273rd/1274th/1275th/1276th/1277th/1278th/1279th/1280th/1281st/1282nd/1283rd/1284th/1285th/1286th/1287th/1288th/1289th/1290th/1291st/1292nd/1293rd/1294th/1295th/1296th/1297th/1298th/1299th/1300th/1301st/1302nd/1303rd/1304th/1305th/1306th/1307th/1308th/1309th/1310th/1311st/1312nd/1313th/1314th/1315th/1316th/1317th/1318th/1319th/1320th/1321st/1322nd/1323rd/1324th/1325th/1326th/1327th/1328th/1329th/1330th/1331st/1332nd/1333rd/